

RM OF LA BROQUERIE

WASTEWATER TREATMENT LAGOON EXPANSION

PLAN INDEX

GENERAL INFORMATION

- G11. DRAWING LEGEND, ABBREVIATION INDEX AND KEY PLAN
- G12. OVERALL SITE PLAN

AERATED LAGOON

- L1. EXISTING LAGOON LAYOUT, TEST HOLE LOCATIONS AND CONTOUR LINE PLAN
- L2. AERATED LAGOON LAYOUT PLAN
- L3. AERATED LAGOON SITE DRAINAGE AND PERIMETER FENCING PLAN
- L4. PROPOSED LAGOON EXPANSION WITH AERATED PRIMARY CELL 1 AND CELL 2
- L5. AERATED LAGOON TRUCK TURNAROUND, BUILDING LOCATION AND GRADING PLAN
- L6. DIKE CROSS SECTIONS
- L7. DIKE CROSS SECTIONS
- L8. DIKE CROSS SECTIONS
- L9. DIKE CROSS SECTIONS, PIPE END MARKER AND BALLAST WEIGHT DETAILS
- L10. CONCRETE SPILLWAY AND LAGOON DETAILS
- L11. FENCE, MOTORIZED ACCESS GATE, SILT FENCE, CSTE PAD AND PRECAST CONCRETE CURB DETAILS
- L12. LIQUID LEVEL CONTROL MANHOLE LAYOUT AND DETAILS

PIPING AND ACCESS ROAD

- PR1. PIPING AROUND SEWAGE AERATION BUILDING
- PR2. PIPING, VALVE AND ACCESS ROAD DETAILS

LIFT STATION

- LS1. EXISTING LIFT STATION UPGRADES

SEWAGE AERATION BUILDING STRUCTURAL

- S1. BUILDING ELEVATIONS
- S2. FLOOR PLAN
- S3. DRAINAGE, HOUSEKEEPING PAD AND PORT LOCATION PLAN
- S4. PLUMBING PLAN AND BUILDING CLEANOUT DETAIL
- S5. FOUNDATION PLAN, SLAB ON GRADE AND MISCELLANEOUS DETAILS
- S6. WALL SECTION, WALL AND ROOF DETAILS
- S7. FURNITURE, BUILDING SIGN AND CONCRETE SPLASHPAD DETAILS

PROCESS

- P1. SEWAGE AERATION PROCESS DIAGRAM

MECHANICAL

- M1. MECHANICAL PLAN
- M2. BLOWER PIPING DETAILS
- M3. VENTILATION LAYOUT AND BLOWER AIR PLENUM DETAILS


ELECTRICAL

- E1. ELECTRICAL SITE PLAN
- E2. ELECTRICAL DETAILS
- E3. LIGHTING, POWER AND CONTROL LAYOUT
- E4. ELECTRICAL SINGLE LINE DIAGRAM AND MCC LAYOUT
- E5. PANEL SCHEDULE AND ELECTRICAL EQUIPMENT SCHEDULES
- E6. ELECTRICAL PROCESS LOOP DIAGRAMS

As-Built Drawing

Drawing compiled from visual observations of various parts of construction and/or from information by others. Accuracy not warranted. Independent verification required before application.

REDUCED DRAWING SET DO NOT SCALE

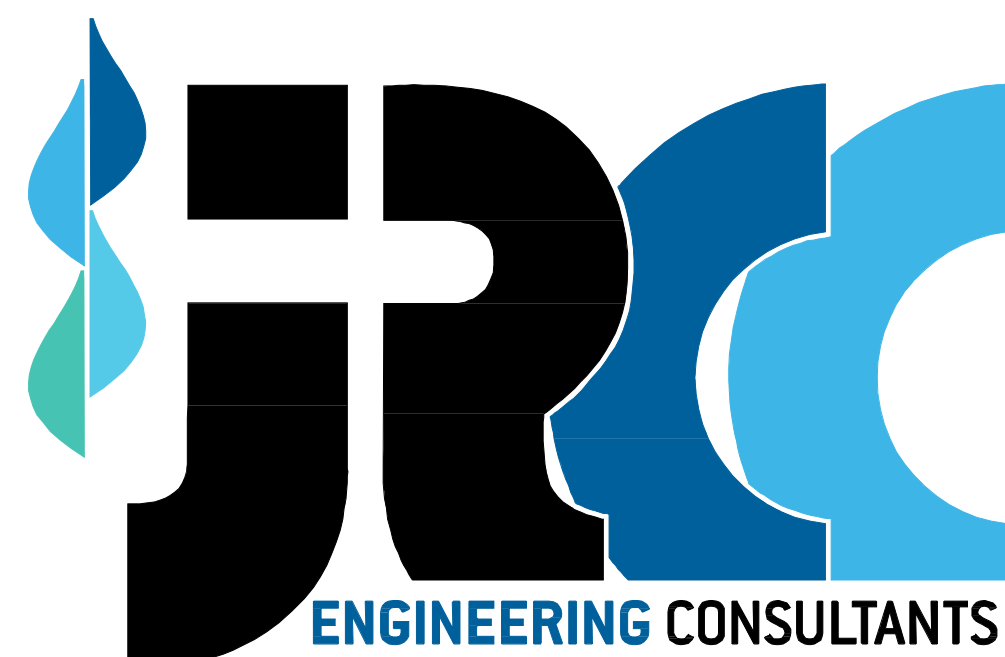

JR Cousin Consultants Ltd.

91A Scurfield Blvd. Winnipeg MB R3Y 1G4

p. (204) 489-0474

f. (204) 489-0487

www.jrcc.ca

ENGINEERING EXCELLENCE SINCE 1981



DRAWING LEGEND:

PIPING:

- EXISTING WATERMAIN
- PROPOSED WATERMAIN
- FUTURE WATERMAIN
- EXISTING SEWERMAIN
- PROPOSED SEWERMAIN
- FUTURE SEWERMAIN
- EXISTING FORCEMAIN
- PROPOSED FORCEMAIN
- FUTURE FORCEMAIN
- EXISTING DISCHARGE
- PROPOSED DISCHARGE
- FUTURE DISCHARGE
- EXISTING RAW WATERMAIN
- PROPOSED RAW WATERMAIN
- FUTURE RAW WATERMAIN
- EXISTING LAND DRAINAGE SEWER
- PROPOSED LAND DRAINAGE SEWER
- FUTURE LAND DRAINAGE SEWER
- FH EXISTING FIRE HYDRANT
- FH PROPOSED FIRE HYDRANT
- ⊕ EXISTING VALVE
- ⊕ PROPOSED VALVE
- ⊕ EXISTING CLEANOUT
- ⊕ PROPOSED CLEANOUT
- MH EXISTING MANHOLE
- MH PROPOSED MANHOLE
- ⊕ EXISTING CURBSTOP
- ⊕ PROPOSED CURBSTOP
- CB EXISTING CATCH BASIN
- CB PROPOSED CATCH BASIN

ROADS AND DRAINAGE:

- EXISTING ROAD CENTERLINE
- PROPOSED ROAD CENTERLINE
- FUTURE ROAD CENTERLINE
- EXISTING ROAD SHOULDER
- PROPOSED ROAD SHOULDER
- EXISTING ROAD EDGE
- PROPOSED ROAD EDGE
- FUTURE ROAD EDGE
- EXISTING SIDEWALK
- PROPOSED SIDEWALK
- EXISTING DITCH
- PROPOSED DITCH
- EXISTING CULVERT
- PROPOSED CULVERT
- EXISTING DRAINAGE DIRECTION
- PROPOSED DRAINAGE DIRECTION
- CONTOURS - MAJOR INTERVALS
- CONTOURS - MINOR INTERVALS
- EXISTING GROUND ELEVATION
- PROPOSED GROUND ELEVATION
- EXISTING ROAD ELEVATION
- PROPOSED ROAD ELEVATION
- EXISTING SLOPE
- PROPOSED SLOPE

MISCELLANEOUS:

- EXISTING FENCE LINE
- PROPOSED FENCE LINE
- EXISTING HYDRO LINE
- PROPOSED HYDRO LINE
- EXISTING GAS LINE
- EXISTING MTS LINE
- EXISTING BUILDING
- PROPOSED BUILDING
- LEGAL/LOT LINE
- RAILWAY LINE
- MATCH LINE
- HP HYDRO POLE
- ⊕ WATER HOLDING TANK
- ⊕ SEPTIC TANK
- ⊕ SEWAGE HOLDING TANK
- ⊕ SURVEY BAR
- ⊕ SURVEY MONUMENT/BENCHMARK
- ⊕ TEST HOLE
- ⊕ AMEC TH# TEST HOLE BY AMEC JANUARY 2014
- EXISTING VEGETATION
- PROPOSED VEGETATION
- ⊕ DOOR CONSTRUCTION TYPE
- ⊕ WALL CONSTRUCTION TYPE
- EASEMENT
- ⊕ NORTH ARROW

EQUIPMENT:


- ⊕ PUMP
- ⊕ MAG METER
- ⊕ GATE VALVE (GENERAL)
- ⊕ BALL VALVE
- ⊕ BUTTERFLY VALVE
- ⊕ FLOW DIRECTION
- ⊕ FLANGE CONNECTION
- ⊕ PRESSURE GAUGE
- ⊕ MOTORIZED VALVE (ANALOG - CONTROL)
- ⊕ REDUCER

ABBREVIATIONS:


- | | | | |
|---|--|----------------------------|--------------------|
| ⊕ AT | E EAST | JCT JUNCTION | RAD RADIUS |
| A/C AIR CONDITIONING | EC END OF CURVE | JP JOCKEY PUMP | RD ROAD |
| ALUM ALUMINUM | EL ELEVATION | LAB LABORATORY | REV REVISION |
| ASPH ASPHALT | ELEC ELECTRICAL | LAM LAMINATE | ROW RIGHT OF WAY |
| AVE AVENUE | EP EDGE OF PAVEMENT | LAT LATITUDE | ROOM ROOM |
| AVG AVERAGE | ER EDGE OF ROAD | LDS LAND DRAINAGE SEWER | S SOUTH |
| | E/W EACHWAY | LF LEVEL FLOAT | SCH SCHEDULE |
| | EXT EXTERIOR | LLF LOW LEVEL FLOAT | SECT SECTION |
| BD BOTTOM OF DITCH | | LWG LONGITUDE | SHT SHEET |
| BLDG BUILDING | FAX FAX MACHINE STAND | LWL LOW WATER LEVEL | SIB STEEL IRON BAR |
| BLVD BOULEVARD | FC FILE CABINET | | SPEC SPECIFICATION |
| BM BENCHMARK | FD FLOOR DRAIN | M METRE | SQ SQUARE |
| BOT BOTTOM | F/F FACE TO FACE | MAX MAXIMUM | SS SOUTH SHORE |
| BP BACKWASH PUMP | FH FIRE HYDRANT | MCC MOTOR CONTROL CENTER | ST STREET |
| B/W BOTHWAYS | FM FORCEMAIN | MECH MECHANICAL | STD STANDARD |
| | FP FIRE PUMP | MEMB MEMBRANE | SUSP SUSPENDED |
| CB CATCH BASIN | FT FOOT, FEET | MH MANHOLE | SW SIDEWALK |
| CI CAST IRON | | MIN MINIMUM | TEL TELEPHONE |
| CHKD CHECKED | GA GAUGE | MM MILLIMETRE | TEMP TEMPORARY |
| CNR CANADIAN NATIONAL RAILWAY | GALV GALVANIZED | | TP TRUCKFILL PUMP |
| CO CLEANOUT | GAV GATE VALVE | N NORTH | TYP TYPICAL |
| COL COLUMN | | NAT NATURAL | VERT VERTICAL |
| CONC CONCRETE | HA HECTARE | NBC NATIONAL BUILDING CODE | VOL VOLUME |
| CONST CONSTRUCTION | HB HOSE BIBB | NS NORTH SHORE | |
| CONT CONTINUOUS | HI HEIGHT OF INSTRUMENT | NTS NOT TO SCALE | |
| COORD COORDINATE | HLF HIGH LEVEL FLOAT | NWL NORMAL WATER LEVEL | |
| CPR CANADIAN PACIFIC RAILWAY | HPW HIGH PRESSURE WATER LINE | O/C ON CENTRE | |
| C/W COMPLETE WITH | HORIZ HORIZONTAL | O/D OUTSIDE DIAMETER | |
| CSTE CUSTOMER SERVICE TERMINAL ENTRANCE | HP HYDRO POLE | O/F OUTSIDE FACE | |
| | HST HYDROSTATIC TRANSDUCER | O/H OVER HEAD | |
| | HR HOUR | OD OUTSIDE DIAMETER | |
| | HVAC HEATING, VENTILATING AND AIR CONDITIONING | ORIG ORIGINAL | |
| | DHW DOMESTIC HOT WATER | OWSJ OPEN WEB STEEL JOIST | |
| DIA DIAMETER | HWL HIGH WATER LEVEL | | |
| DIM DIMENSION | | PLYWD PLYWOOD | |
| DIST DISTANCE | | PS PRESSURE SEWER | |
| DN DOWN | ID INSIDE DIAMETER | POLY POLYETHYLENE | |
| DP DUTY PUMP | IL ICE LEVEL | PROP PROPERTY | |
| DR DRIVE | INCL INCLUDE | PVC POLY VINYL CHLORIDE | |
| DWG DRAWING | INT INTERIOR | | |
| | INV INVERT | | |

INSTRUMENTATION:


- ⊕ TEMPERATURE TRANSMITTER
- ⊕ DIFFERENTIAL PRESSURE GAUGE
- ⊕ PRESSURE TRANSDUCER

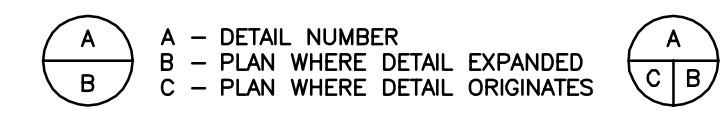

NOTE:
 - WHOLE NUMBERS INDICATE MILLIMETERS
 - DECIMALIZED NUMBERS REPRESENT METERS

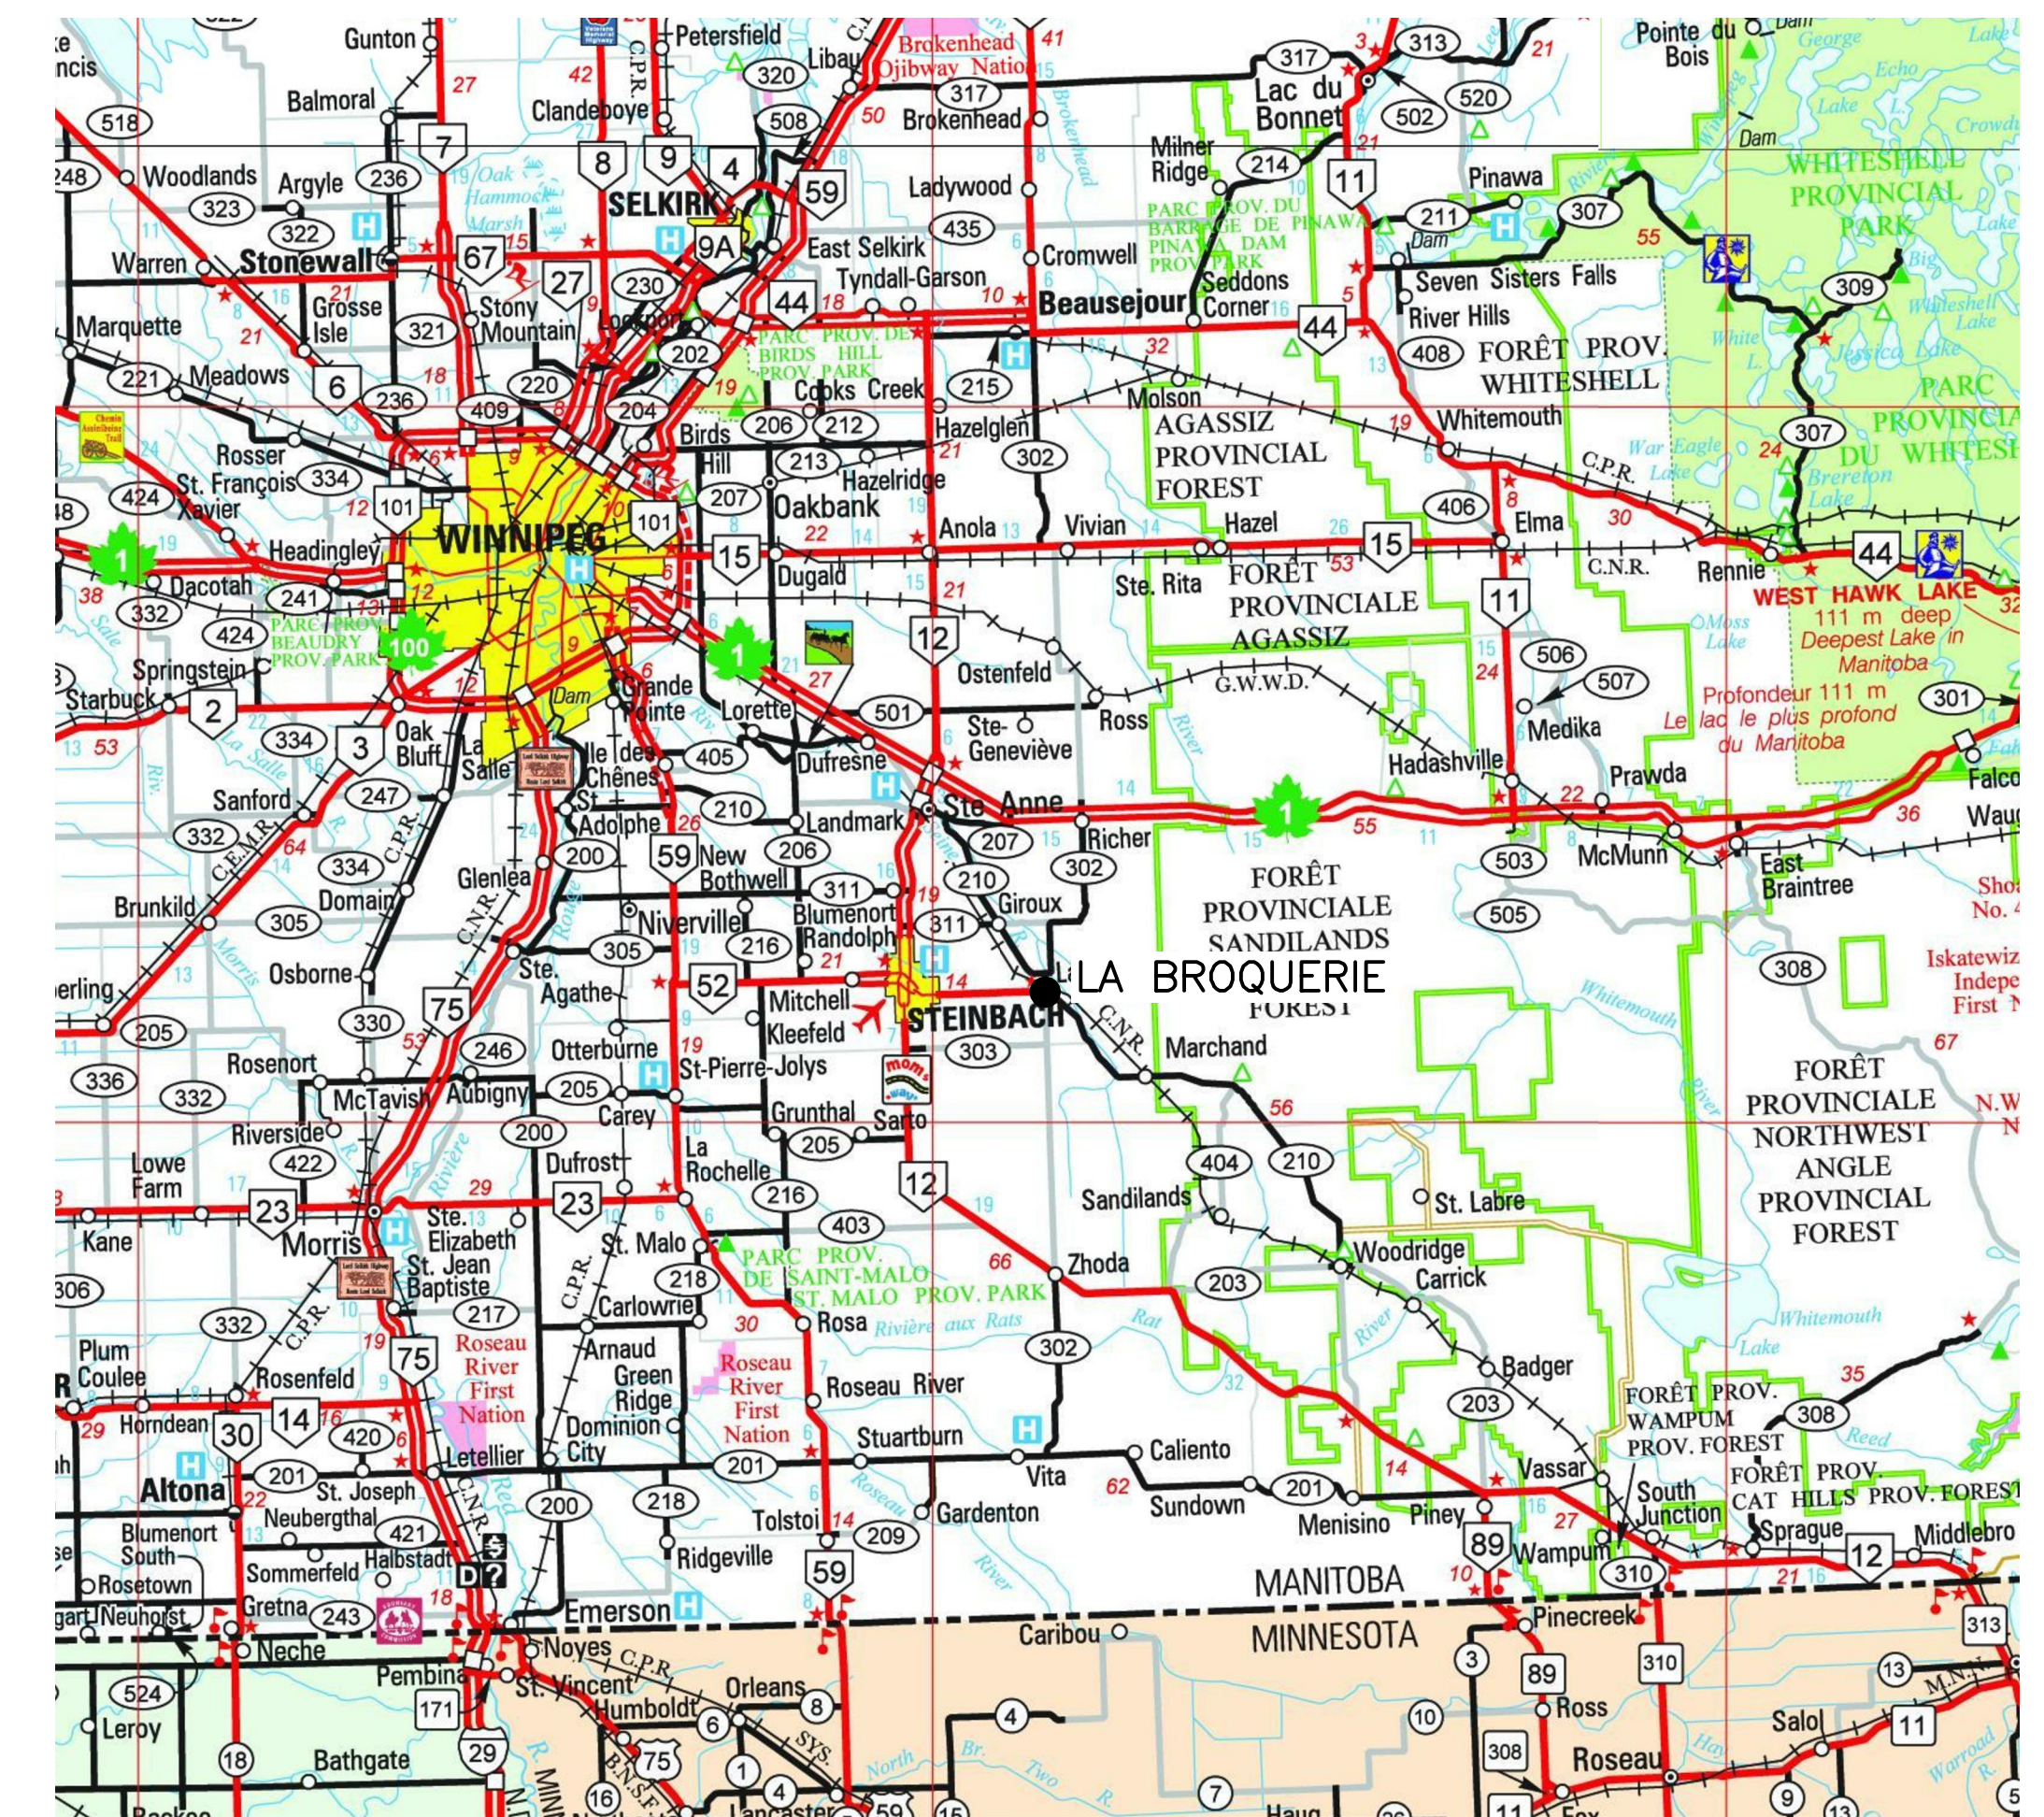

KEY PLAN
 SCALE = NTS

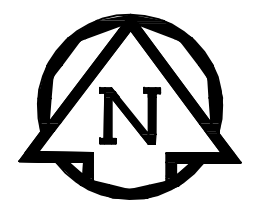

Mar 05, 2018 - 11:23am E:\105\1051\1051 - La Broquerie\WWT Lagoon Expansion\Plan-Design and Design\04 - Drawing\Legend Drawing\01.dwg

No.	REVISIONS	DATE	INITIALS
2	AS BUILT DRAWING	2018/03	RH
1	ISSUED FOR TENDER	2016/08	OT

B.M. EL.
 REFER TO PLAN G12 FOR BENCHMARK LOCATION

LOCATIONS OF UNDERGROUND STRUCTURES/UTILITIES AS SHOWN ARE BASED ON AVAILABLE INFORMATION BUT NO GUARANTEE IS GIVEN OR IMPLIED THAT ALL EXISTING UNDERGROUND STRUCTURES/UTILITIES ARE SHOWN OR THAT THE GIVEN LOCATIONS ARE EXACT. CONFIRMATION OF EXISTENCE AND EXACT LOCATION OF ALL UNDERGROUND STRUCTURES/UTILITIES MUST BE OBTAINED FROM THE APPROPRIATE AUTHORITY/OWNER, BY THE CONTRACTOR, BEFORE PROCEEDING WITH CONSTRUCTION.

ENGINEER'S SEAL

ORIGINAL DRAWING SIGNED AND SEALED BY
 B.J.D. MCCORMAC
 16/08/18

JRC ENGINEERING CONSULTANTS


JR Cousin Consultants Ltd.
 91A Scurfield Blvd. Winnipeg MB R3Y 1G4
 p. (204) 489-0474
 f. (204) 489-0487
 www.jrcc.ca

ENGINEERING EXCELLENCE SINCE 1981

CODE: L-169.75	PROJECT: RM OF LA BROQUERIE WASTEWATER TREATMENT LAGOON EXPANSION
DESIGNED BY: BM	TITLE: DRAWING LEGEND, ABBREVIATION INDEX AND KEY PLAN
DRAWN BY: OT	
REVIEWED BY: JC	
SCALE: NTS	DATE: 15/05/26
PLAN: G11	SHEET: 1 of 34


As-Built Drawing

Drawing compiled from visual observations of various parts of construction and/or from information by others. Accuracy not warranted. Independent verification required before application.

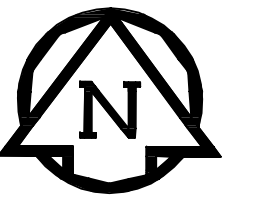

As-Built Drawing


Drawing compiled from visual observations of various parts of construction and/or from information by others. Accuracy not warranted. Independent verification required before application.

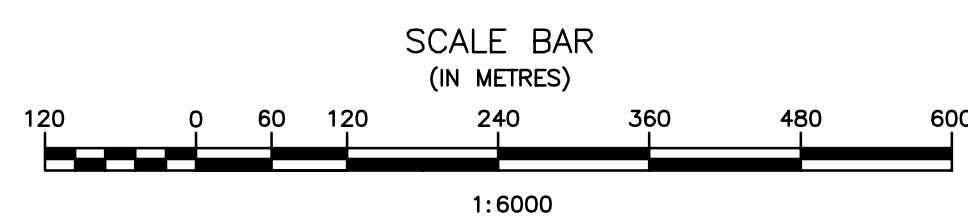

No.	REVISIONS	DATE	INITIALS
2	AS BUILT DRAWING	2018/03	RH
1	ISSUED FOR TENDER	2016/08	OT

B.M. EL.
 PROJECT BENCHMARK: STANDING IRON BAR
 N: 5488867.797
 E: 680166.049
 EL: 283.275

LOCATIONS OF UNDERGROUND STRUCTURES/UTILITIES AS SHOWN ARE BASED ON AVAILABLE INFORMATION BUT NO GUARANTEE IS GIVEN OR IMPLIED THAT ALL EXISTING UNDERGROUND STRUCTURES/UTILITIES ARE SHOWN OR THAT THE GIVEN LOCATIONS ARE EXACT. CONFIRMATION OF EXISTENCE AND EXACT LOCATION OF ALL UNDERGROUND STRUCTURES/UTILITIES MUST BE OBTAINED FROM THE APPROPRIATE AUTHORITY/OWNER, BY THE CONTRACTOR, BEFORE PROCEEDING WITH CONSTRUCTION.

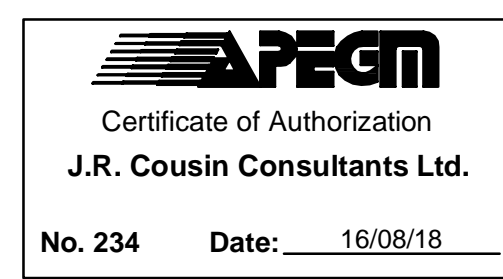

ENGINEER'S SEAL
 ORIGINAL DRAWING
 SIGNED AND SEALED
 BY
 B.J.D. MCCORMAC
 16/08/18

JR Cousin Consultants Ltd.
 91A Scurfield Blvd. Winnipeg MB R3Y 1G4
 p. (204) 489-0474
 f. (204) 489-0487
 www.jrcc.ca

CODE: L-169.75	PROJECT: RM OF LA BROQUERIE WASTEWATER TREATMENT LAGOON EXPANSION
DESIGNED BY: BM	TITLE: OVERALL SITE PLAN
DRAWN BY: OT	
REVIEWED BY: JC	
SCALE: 1:6000	DATE: 15/05/26
PLAN: G12	SHEET: 2 of 34

Mar 05, 2018 - 11:25am D:\160169 LA Broquerie\16075 Lagoon Expansion_Plan-Design and Design\04_Drawing\Record_Drawing\022.dwg